


- NOTES:
1. THE EAST GATE STRUCTURE AND LOCATION WAS PROVIDED BY EHLIN SPIESS & HAIGHT, INC. STRUCTURAL ENGINEERS.
 2. THE EAST ENTRANCE ROADWAY BACKGROUND REFERRED TO THE OLD DESIGN PLAN PROVIDED BY PENFIELD & SMITH, INC.
 3. THE EXISTING UTILITIES AS SHOWN WERE REFERENCED FROM THE AVAILABLE CAMPUS UTILITY ATLAS INFORMATION.
- ATTENTION: CLOUDED ITEMS ADDED TO PLAN AFTER POT HOLES WAS COMPLETED.
1. CONFIRM ELECTRICAL LINES AND JUNCTION BOXES SHOWN PER EAST ENTRANCE STREET LIGHTING PLAN.
 2. CONFIRM UTILITY TYPE, IDENTIFIED BY CONTRACTOR AS STREET LIGHT CONDUIT.

RECORD DRAWING

THIS DRAWING HAS BEEN REVISED TO REFLECT THE CONTRACTORS' FIELD OBSERVATIONS AND FIELD MEASUREMENTS. THE CONTRACTOR'S APPROVED CHANGE ORDERS, SAID REVISIONS MAY ALSO REFLECT THE OBSERVATIONS BY THE OWNER'S REPRESENTATIVES. THE PROJECT ENGINEER DOES NOT GUARANTEE THE ACCURACY OF INFORMATION SHOWN HEREON. ANY INTERESTED PERSON SHOULD MAKE THEIR OWN FIELD VERIFICATION ON THIS PLAN.

CARRIE E. COLLINS
PROJECT ENGINEER
R.C.E. No. 70345
DATE: 06-11-07
EXPIRES: 09-30-08

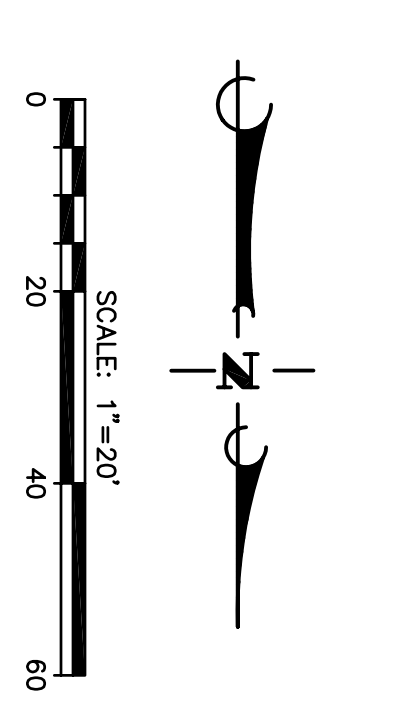


NO.	DATE	REVISIONS	APP'D.

Patfield & Smith
Engineers - Surveyors - Planners
Construction Management

111 East Victoria Street
Phone: (805) 365-5523

San Diego, CA 92101
Fax: (605) 365-8501

DESIGN DEC
PROJECT ENGINEER
R.C.E. 70345

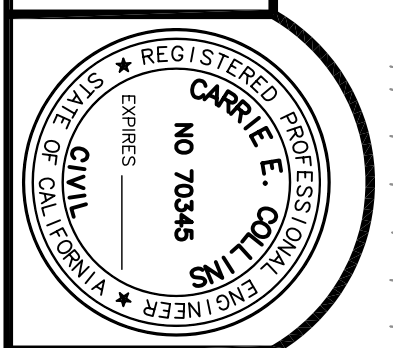

UNIVERSITY OF CALIFORNIA, SANTA BARBARA
REVIEWED BY:
SIGNATURE _____ DATE _____

PLAN AND PROFILE
EAST GATE EXISTING UTILITY CROSSINGS

UNIVERSITY OF CALIFORNIA, SANTA BARBARA

P&S PROJECT NO. 16495.11
SHEET 1 OF 1
PLAN DATE JUNE 2007